

**Resolution NO 2014-45**

**A RESOLUTION ACCEPTING THE EXTENSION OF THREE HUNDRED AND THIRTY (330) LINEAR FEET OF WATERLINE ALONG SAGE LANE INTENDED TO PROVIDE WATER SERVICE FOR LOT # 20**

**WHEREAS** Mr. Steve Larson has installed approximately 330 linear feet of 6" water main and one service line; and

**WHEREAS** Mr. Steve Larson hired Moore Excavation to perform the waterline installation; and

**WHEREAS** the installation of the water line was observed by the Angel Fire Public Utilities Department; and

**WHEREAS** Mr. Steve Larson and Moore Excavation will warranty the waterline installation, to include all aspects of the installation and roadway excavation; and

**WHEREAS** the Public Utilities Department is recommending the Council accept this extension for maintenance with conditions and that the conditions are met by December 17, 2014.

**NOW THEREFORE BE IT RESOLVED** by the Angel Fire Village Council the 330' of 6" water main line extension and one service line along Sage Lane are hereby accepted for maintenance with the following conditions:

1. Sage Lane shall be restored to its pre-construction condition with proper trench compaction as per Village specifications.
2. A one (1) year warranty by Mr. Larson and Moore Construction on all aspects of construction is set from the date of this acceptance.


**PASSED, APPROVED AND ADOPTED** this 17th day of December, 2014.

  
\_\_\_\_\_  
Mayor, Barbara Cottam

  
Attest:   
\_\_\_\_\_  
Terry Cordova, Village Clerk

20 Sage Lane

AS-15115

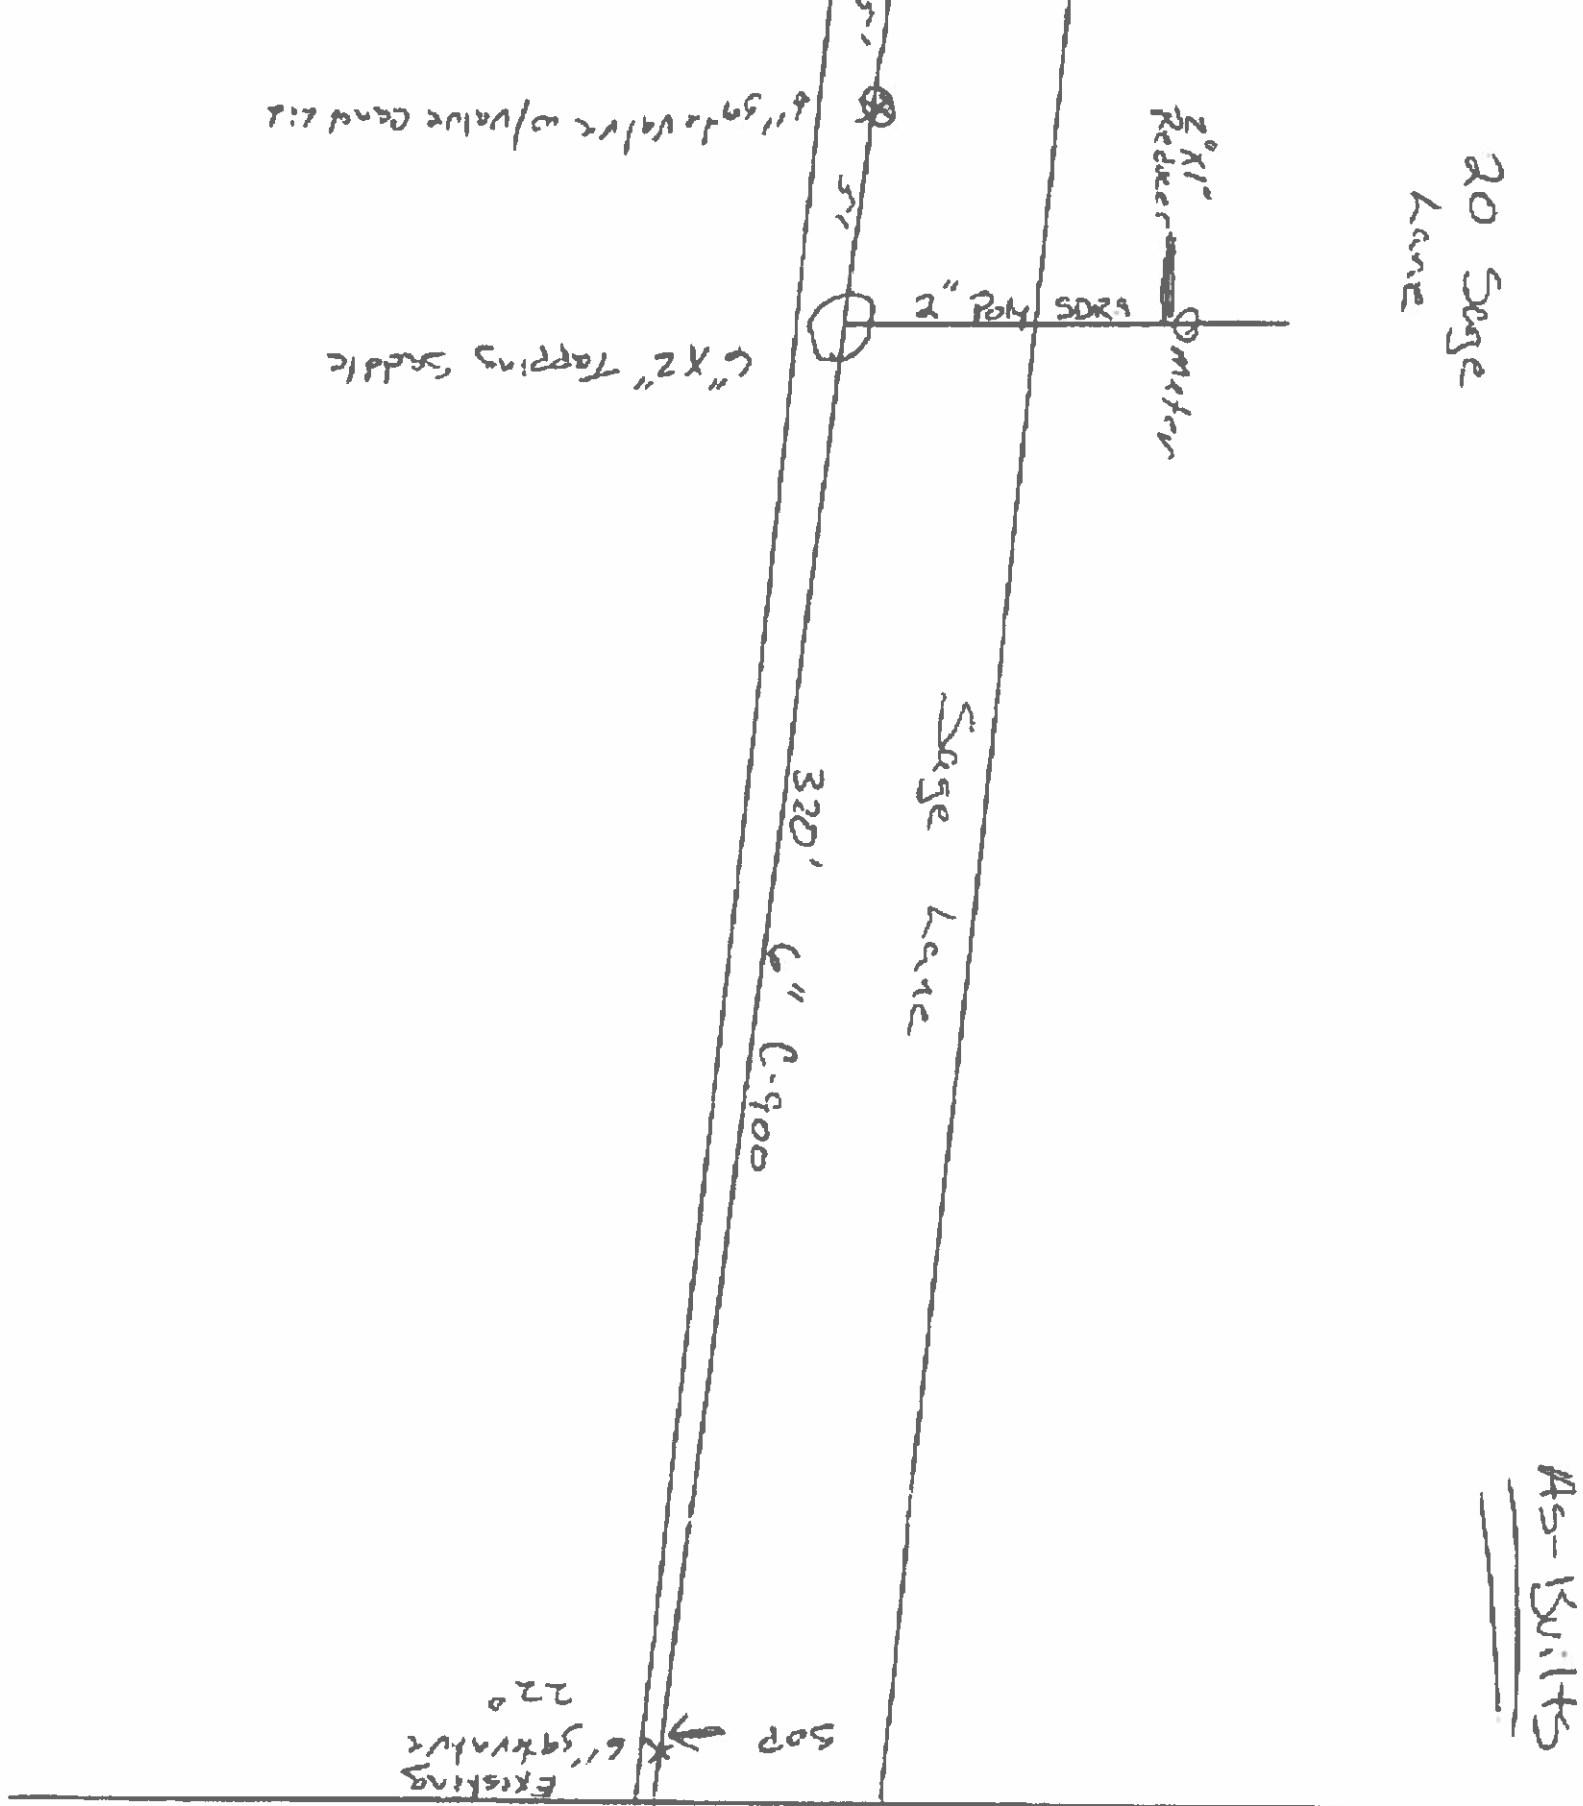

with lift!

December 12, 2014

Village of Angel Fire

3354 Highway 434

Angel Fire, NM 87710

Dear Sirs,

It is hereby requested that an inspection of the work done by Moore Excavation done to Sage Road between Hwy 434 and 20 Sage Lane be inspected for the purpose of acceptance for continued maintenance by the Village of Angel Fire. It is understood that the work be warranted for a period of one year from the date of acceptance by the Village Council of Angel Fire.

Best regards,

Steve Larson



Property owner at 20 Sage Lane